



① GROUND FLOOR PLAN
Scale: 1/4"=1'-0"

| NO. | REVISIONS/ISSUES | DATE |
|-----|------------------|------------|
| - | DATE OF ISSUE | 12.13.2021 |

LEGEND:

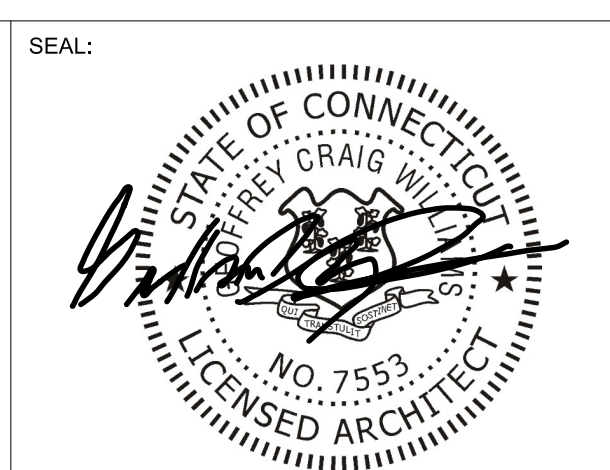


SCALE: As Noted
DATE: Dec 13, 2021 - 12:27pm
DRAWN BY: -
CHECKED BY: -
CADD FILE: 50 Myano _As-Built Plans & Elevations.dwg
PROJECT NO.:

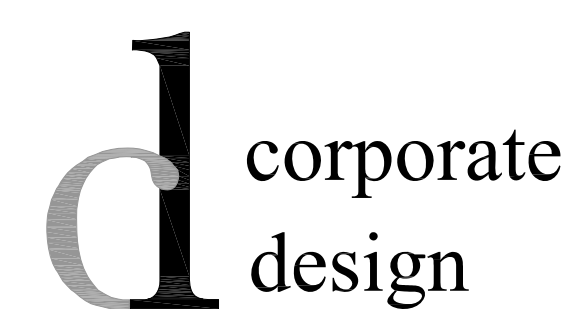

140 Sherman St, Fairfield, CT 06824
203-255-2588 Phone 203-255-2598 Fax

CLIENT/LOCATION:
**50 MYANO LANE
STAMFORD, CT**
**AS-BUILT
AB-1**

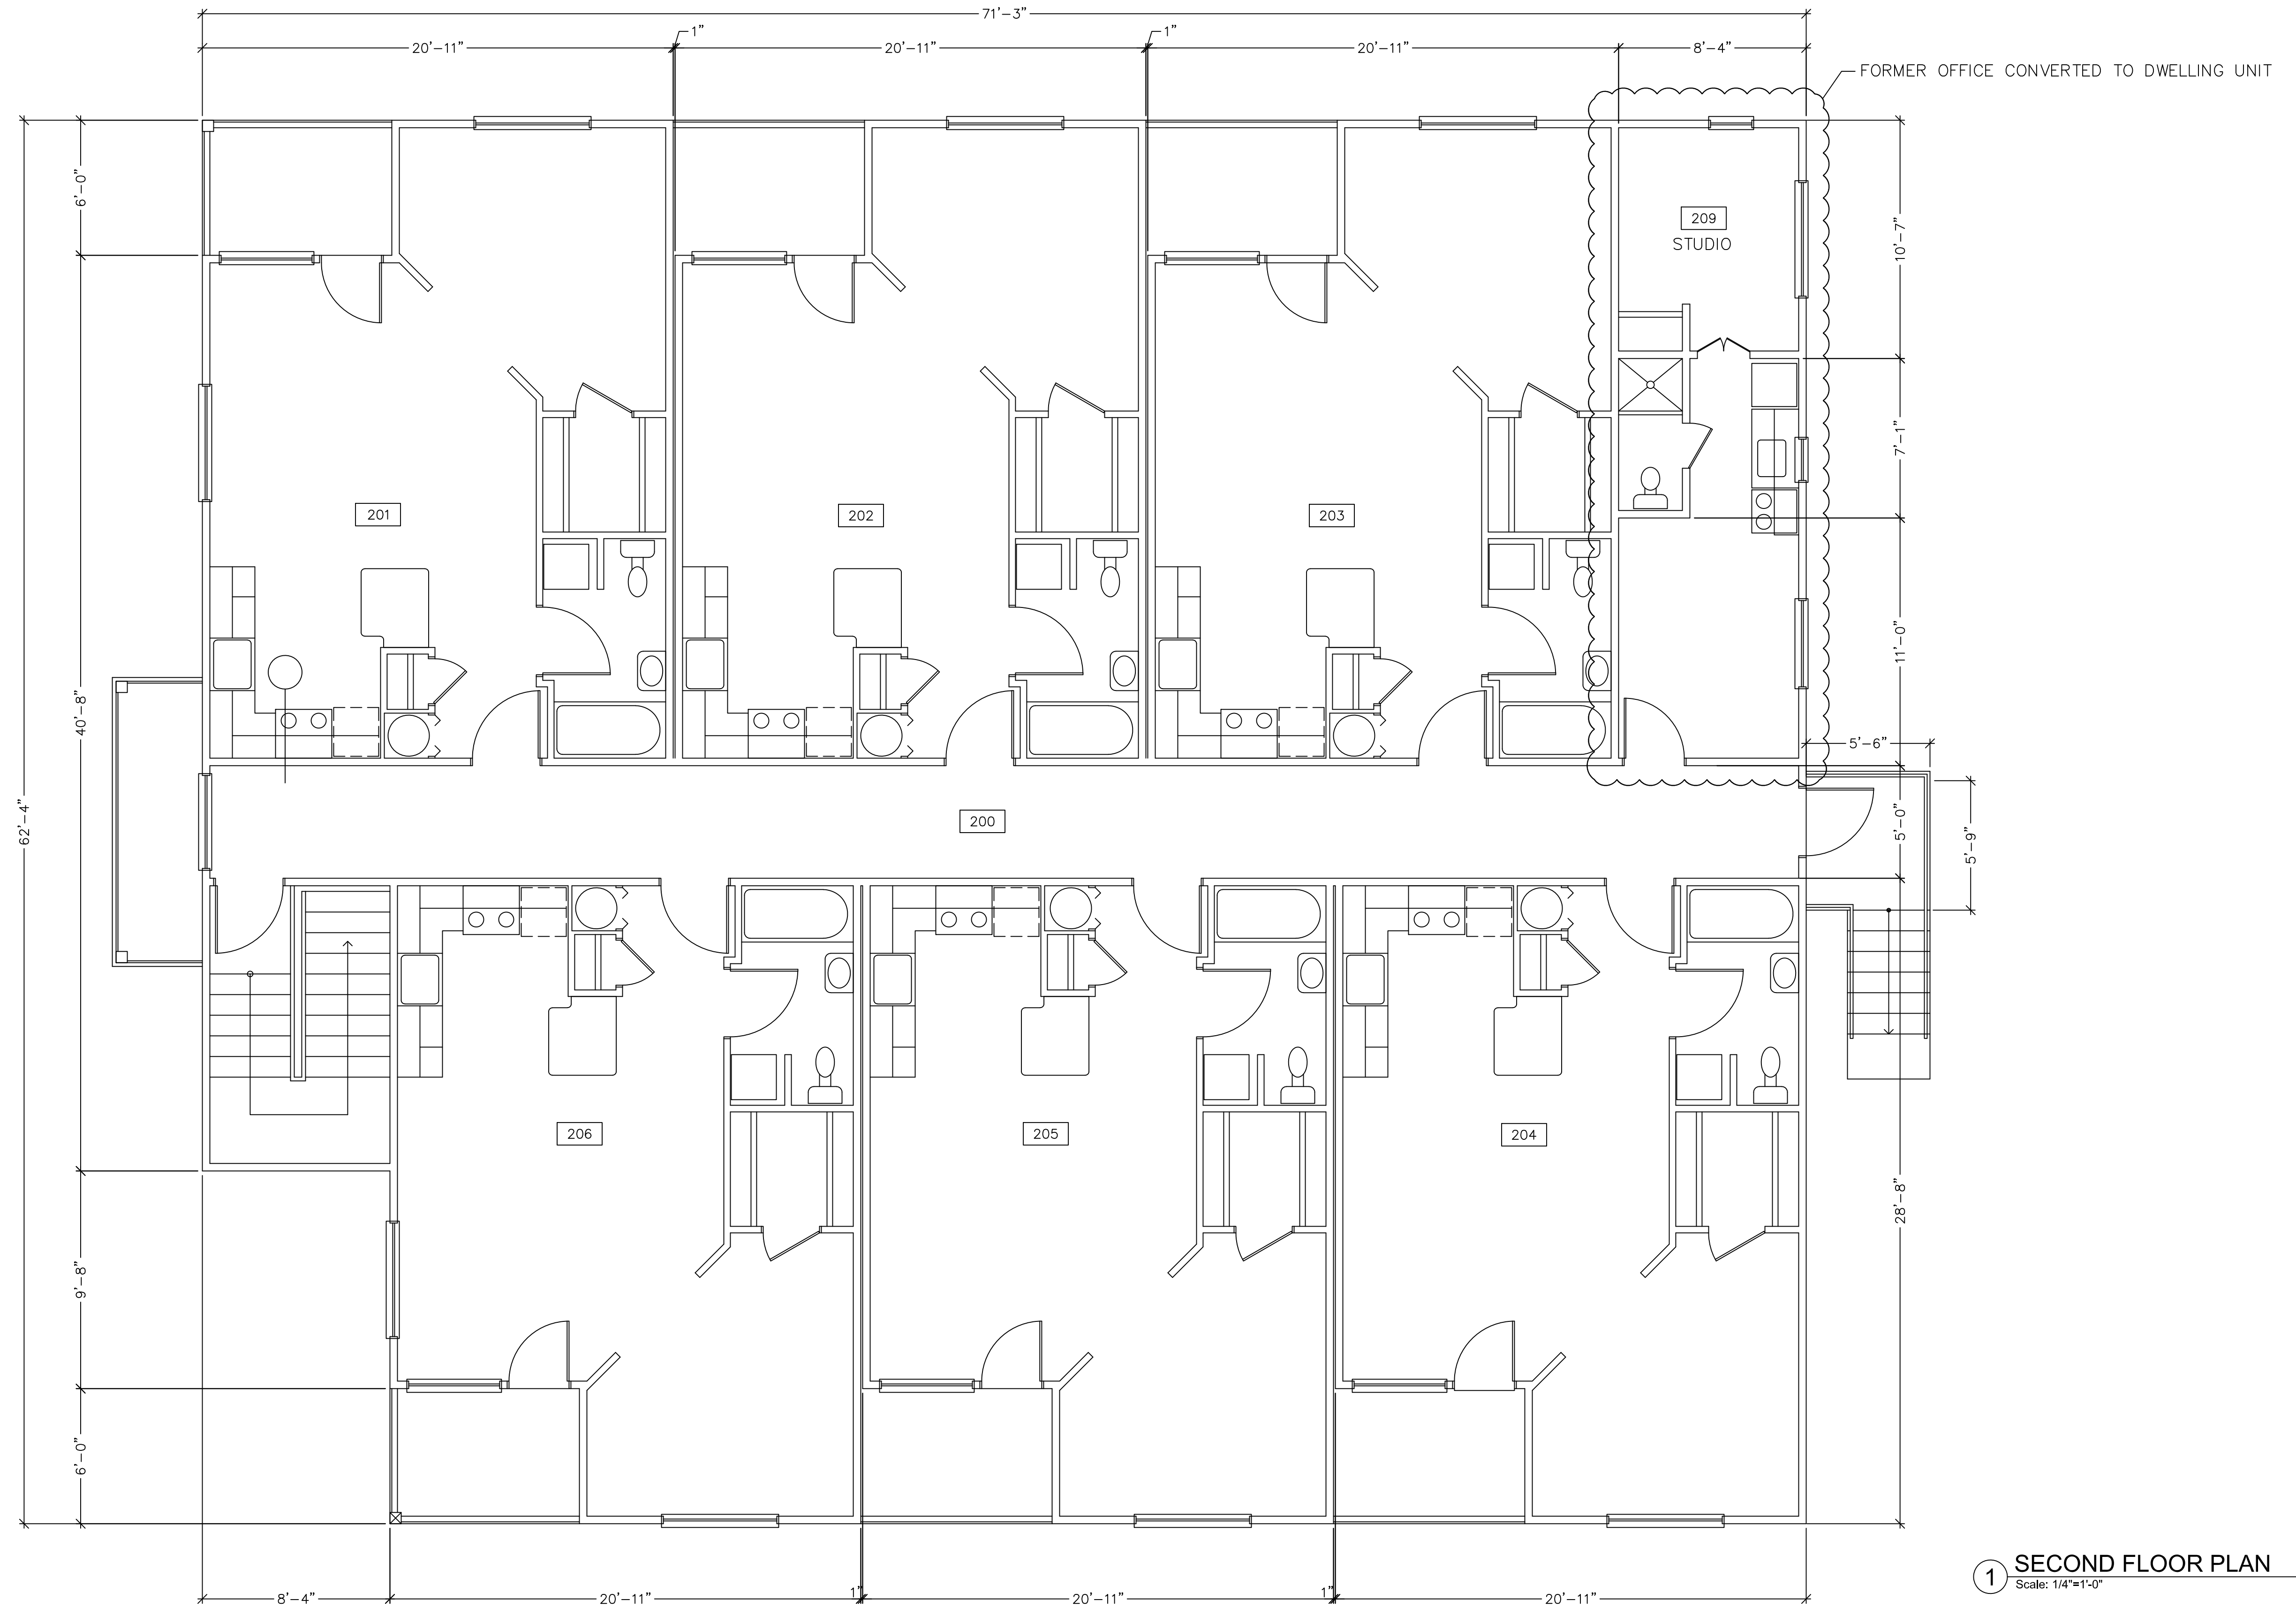

1 SECOND FLOOR PLAN
 Scale: 1/4"=1'-0"

| LEGEND: | |
|----------------------|------------|
| | |
| | |
| DATE OF ISSUE | 12.13.2021 |
| NO. REVISIONS/ISSUES | DATE |

SEAL:



SCALE:
As Noted


DRAWN BY:
-

CHECKED BY:
-

CADD FILE:
50 Myano _As-Built Plans & Elevations.dwg

DATE:
Dec 17, 2021 - 9:37am

PROJECT NO.:

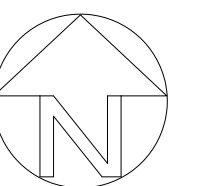


d corporate design

140 Sherman St, Fairfield, CT 06824
 203-255-2588 Phone 203-255-2598 Fax


CLIENT/LOCATION:

50 MYANO LANE
 STAMFORD, CT

AS-BUILT
 AB-2

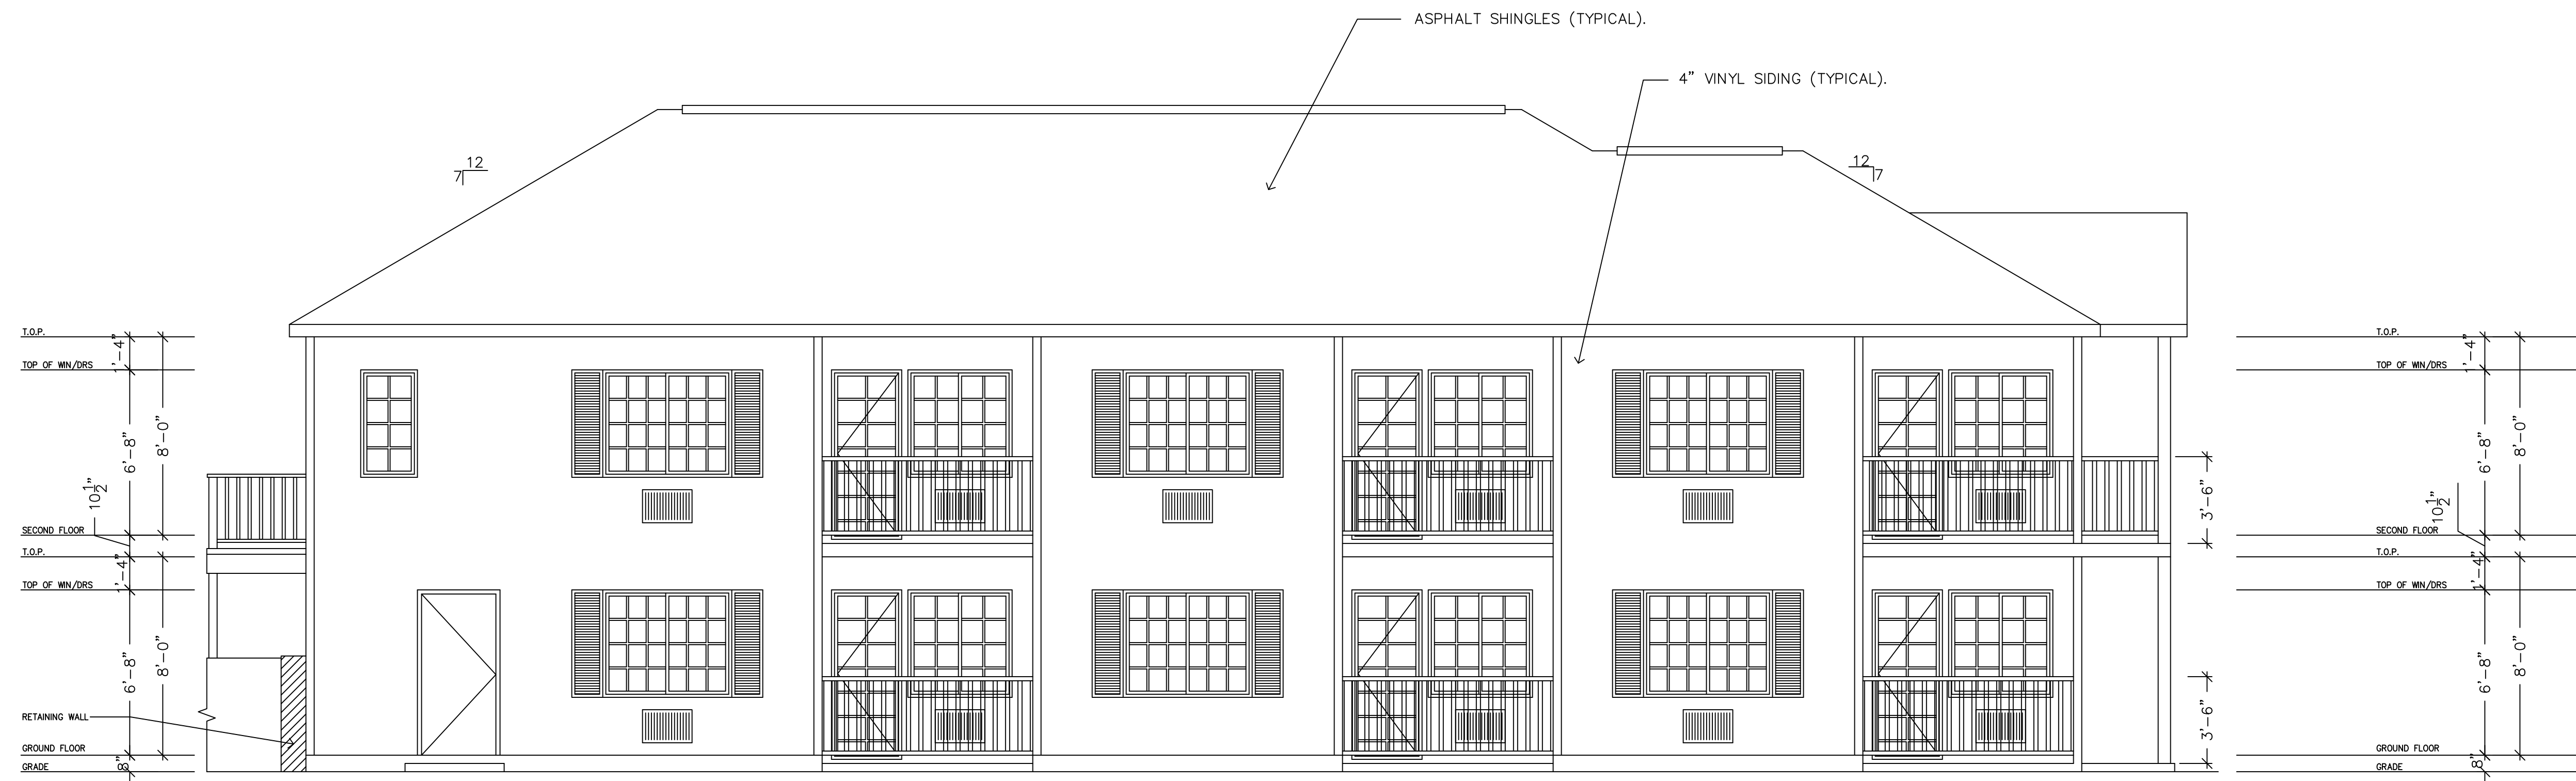


1 REAR ELEVATION
Scale: 1/4"=1'-0"

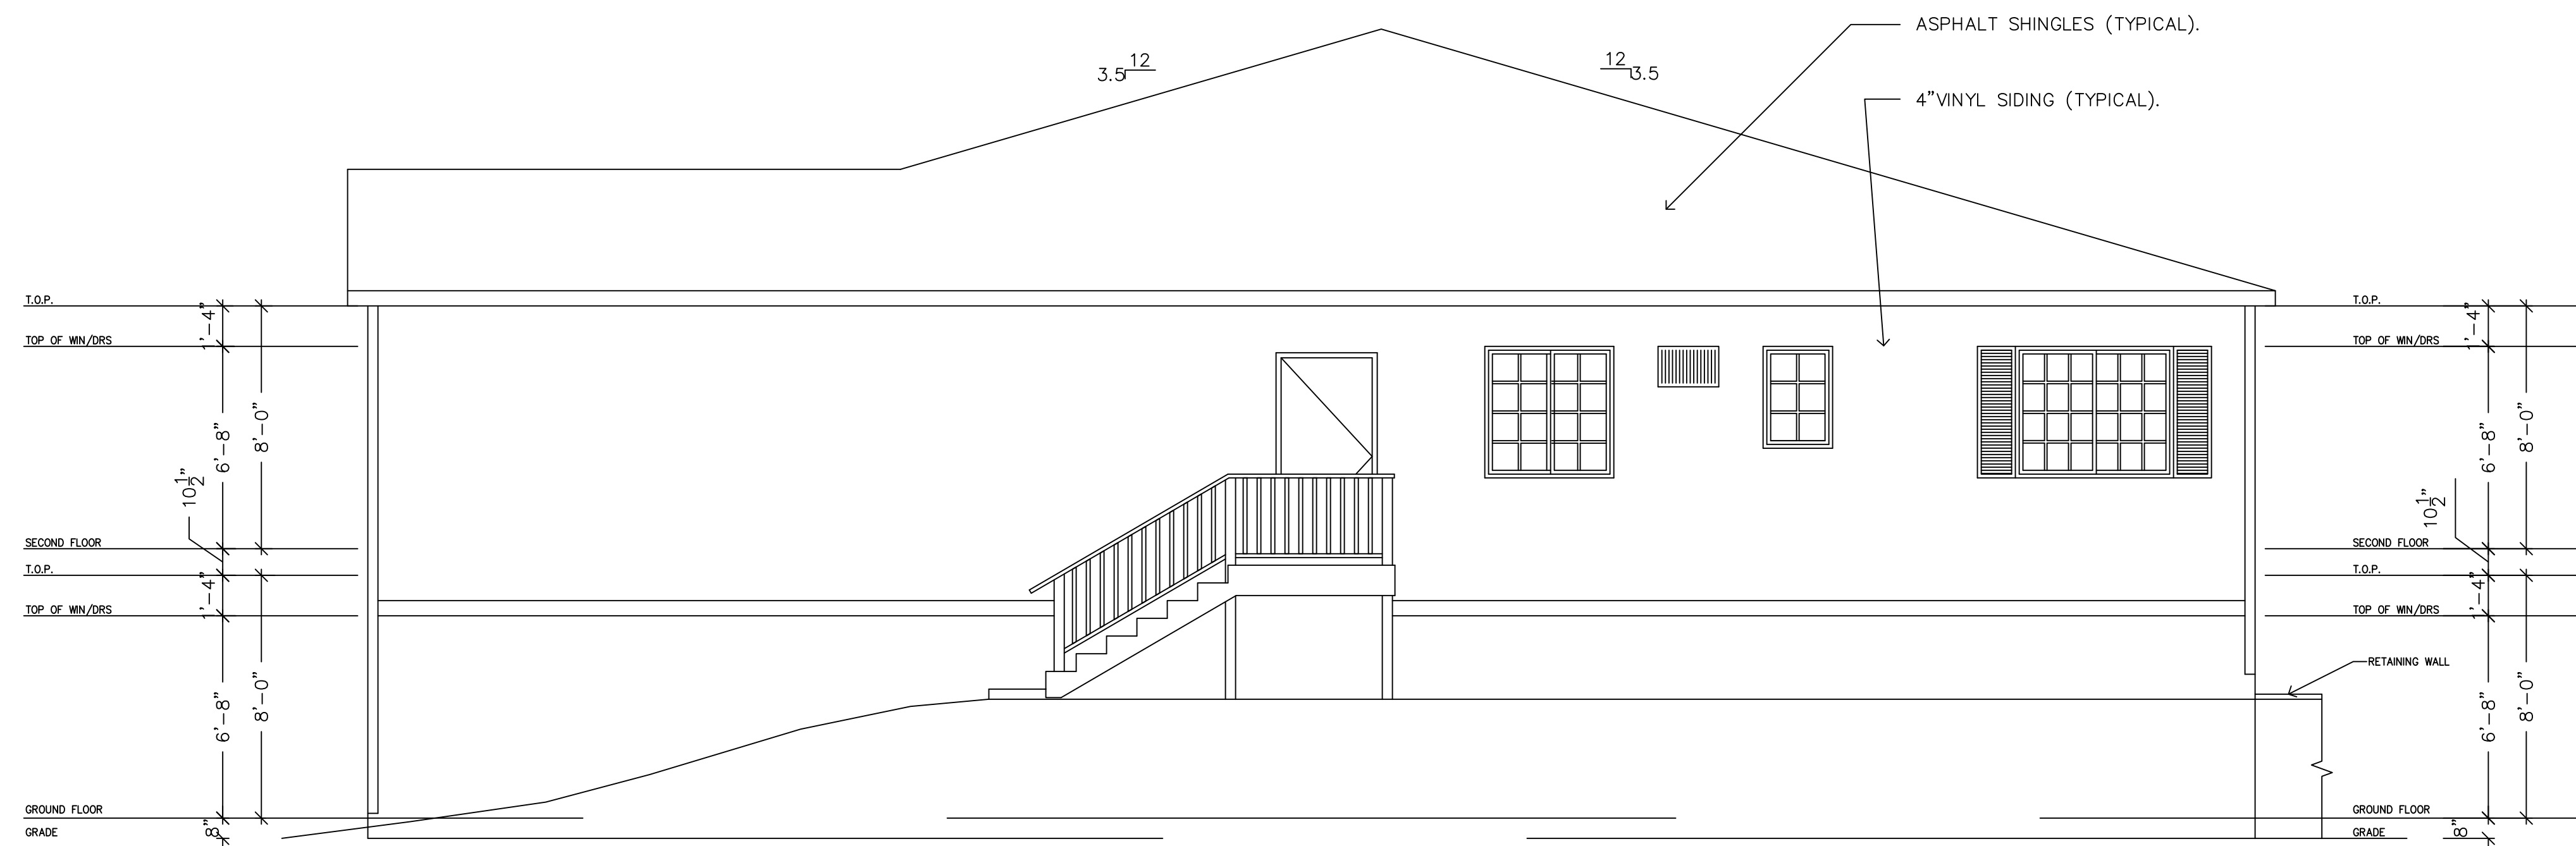

2 SIDE ELEVATION - NORTH
Scale: 1/4"=1'-0"

| NO. | REVISIONS/ISSUES | DATE |
|-----|------------------|------------|
| - | DATE OF ISSUE | 12.13.2021 |

| LEGEND: | |
|---------|--|
| | |
| | |
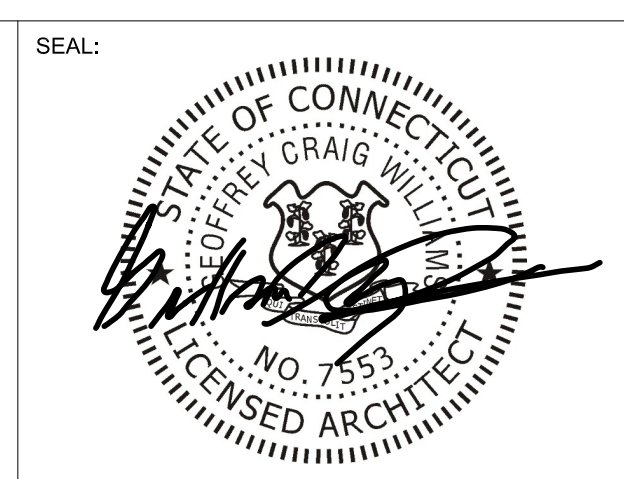

| | |
|---|-----------------------|
| SCALE : | DATE: |
| As Noted | Dec 17, 2021 - 9:40am |
| DRAWN BY: | PROJECT NO.: |
| - | |
| CHECKED BY: | |
| - | |
| CADD FILE: | |
| 50 Myano _As-Built Plans & Elevations.dwg | |

d corporate design
140 Sherman St, Fairfield, CT 06824
203-255-2588 Phone 203-255-2598 Fax

| | |
|-------------------|-------------------------------|
| CLIENT/LOCATION : | 50 MYANO LANE STAMFORD, CT |
| | AS-BUILT |
| | AB-3 |

This drawing is the property of Corporate Design, LLC and must not be reproduced in hard copy or electronic form for any other purpose than that which it was specifically furnished.

Do Not Scale Drawing - Use Dimensions Only

